REVISIONS

PROJECT REFERENCE NO.	SHEET NO.
A-9WM	4
R /W SHEET NO.	
HYDRAULICS ENGINEER	

AS-BUILT PLANS

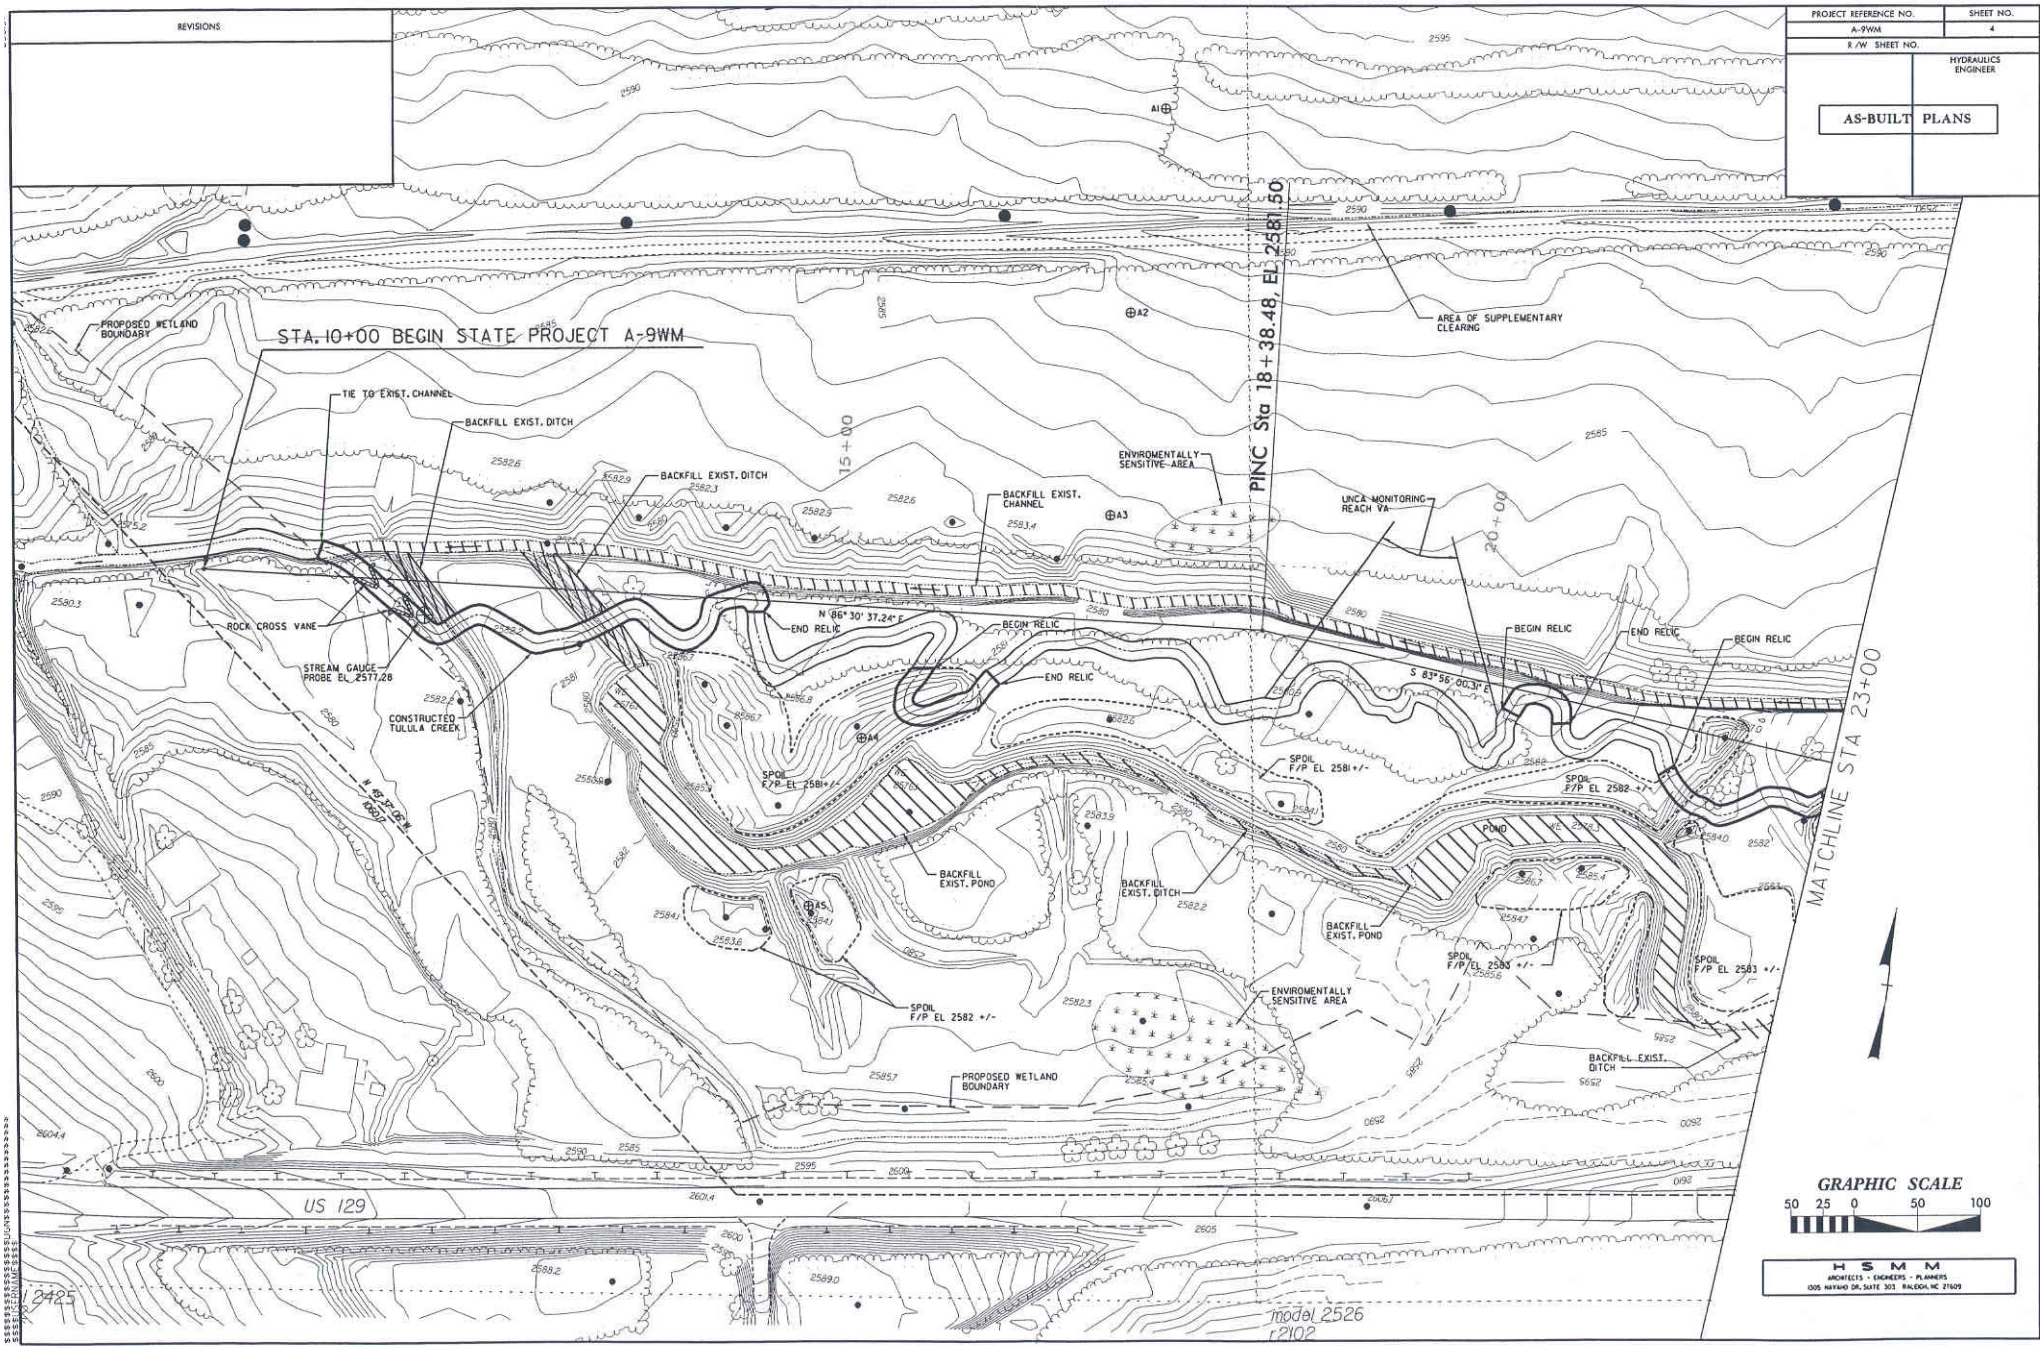

REVISIONS

PROJECT REFERENCE NO.	SHEET NO.
A-9WM	5
R./W SHEET NO.	
	HYDRAULICS ENGINEER

AS-BUILT PLANS

H S M M
ARCHITECTS - ENGINEERS - PLANNERS
1505 HAYWOOD DR. SUITE 303 RALEIGH, NC 27609

REVISIONS

PROJECT REFERENCE NO.	SHEET NO.
A-9WM	6
R/W SHEET NO.	
	HYDRAULICS ENGINEER

AS-BUILT PLANS

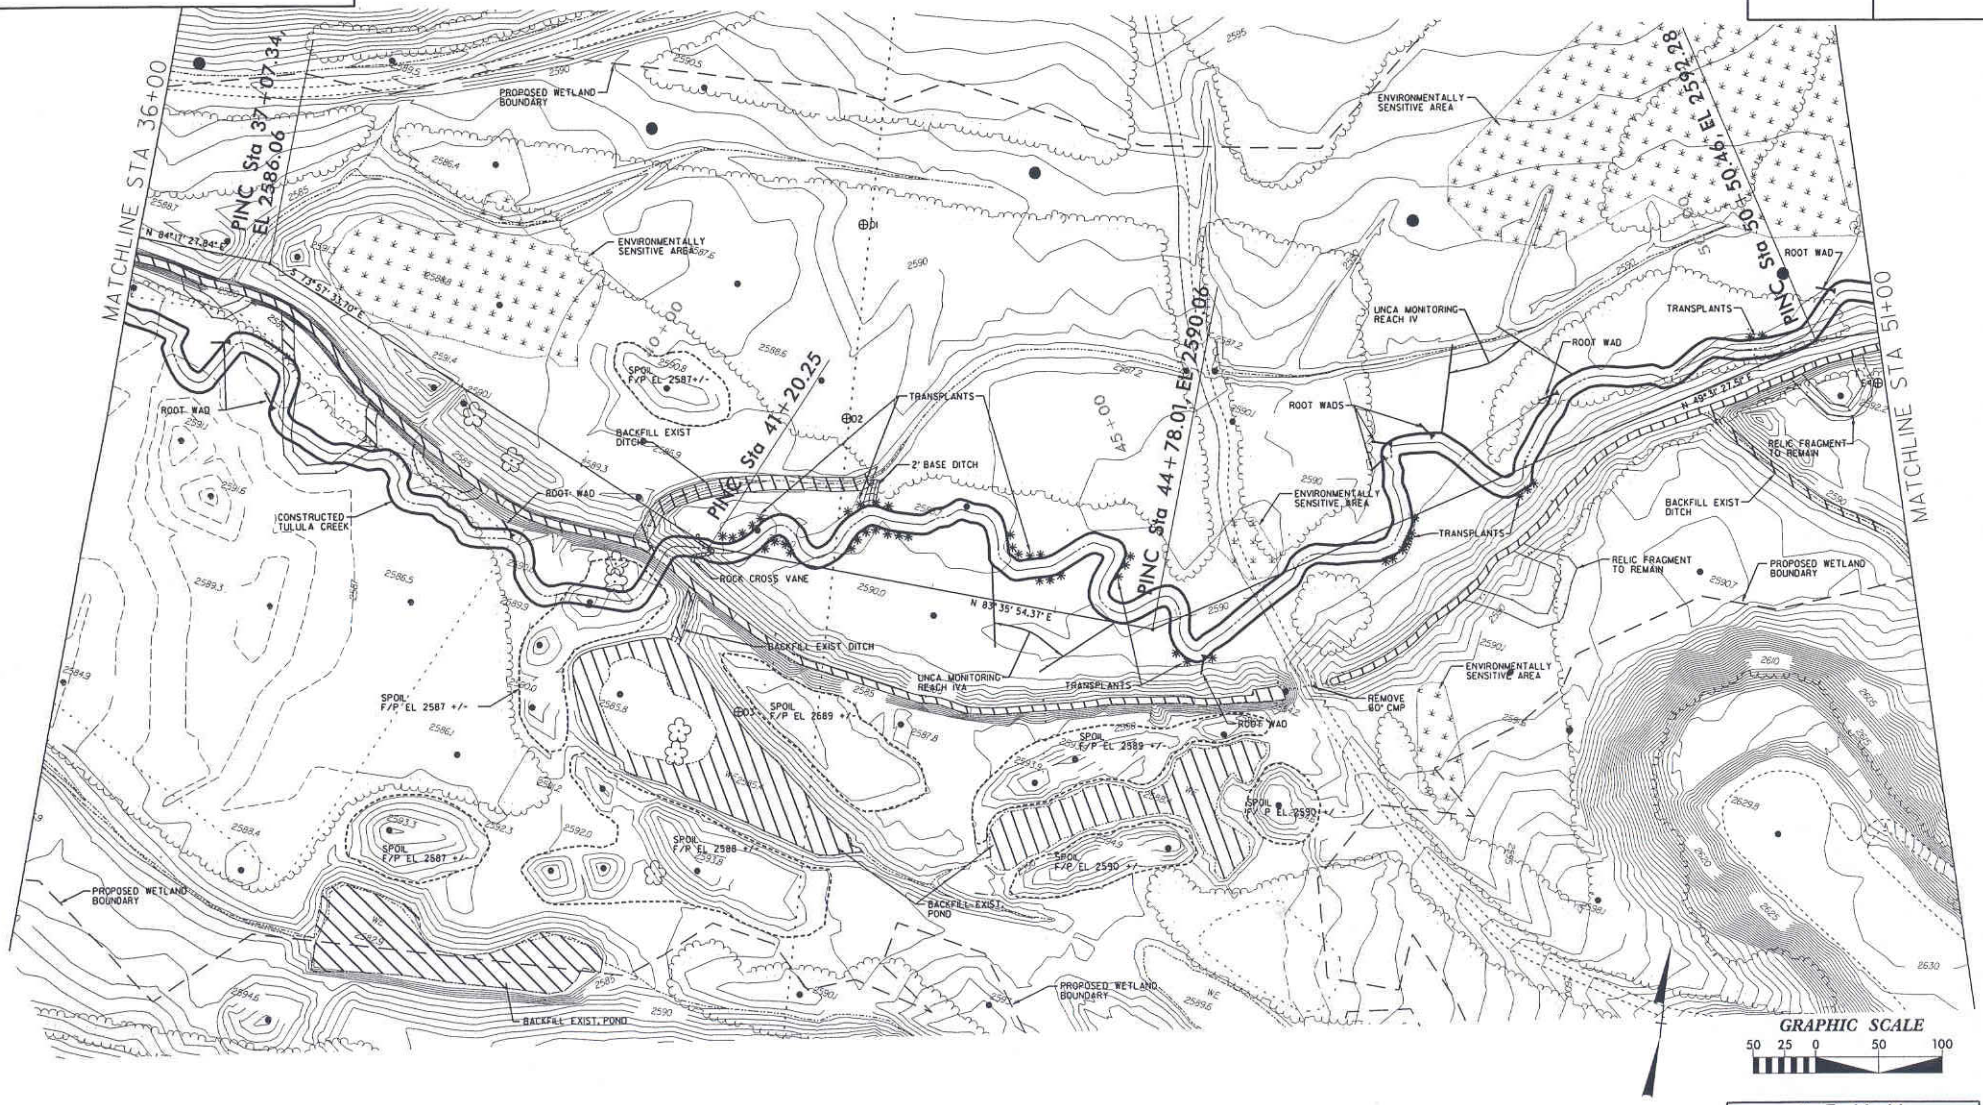

H S M M
ARCHITECTS · ENGINEERS · PLANNERS
1305 NAVAHO DR. SUITE 303 RALEIGH, NC 27609

REVISIONS

PROJECT REFERENCE NO.	SHEET NO.
A-9WM	7
R/W SHEET NO.	
	HYDRAULICS ENGINEER

AS-BUILT PLANS

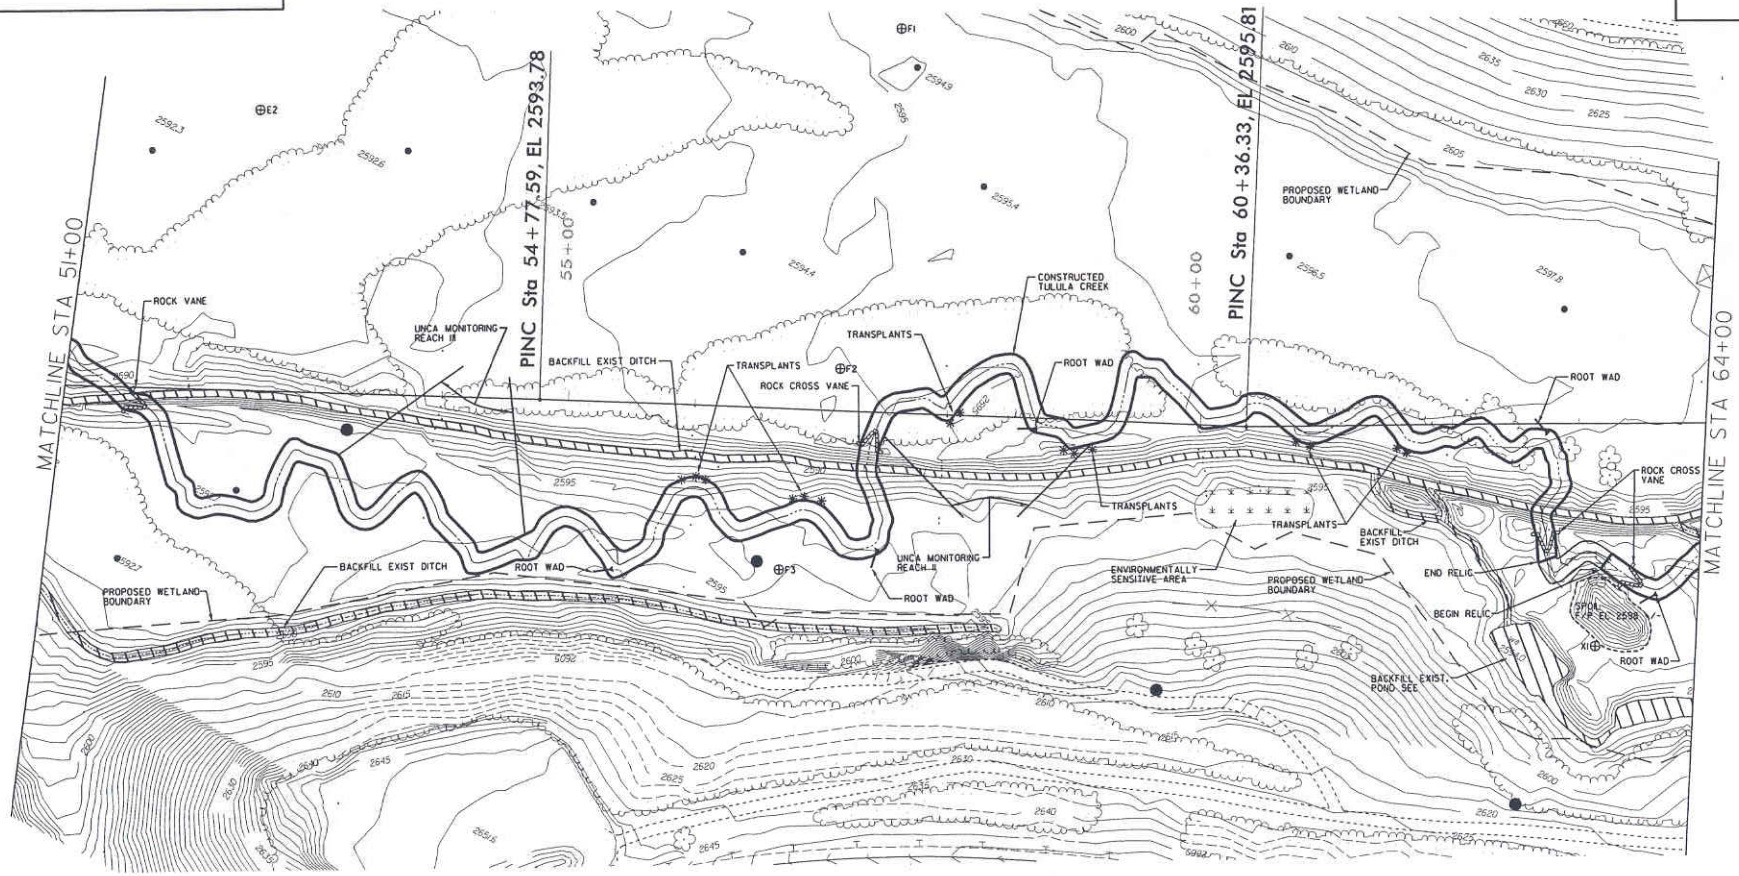

GRAPHIC SCALE

50 25 0 50 100

H S M M
ARCHITECTS • ENGINEERS • PLANNERS
1305 NAVAHO DR. SUITE 303 RALEIGH NC 27609

REVISIONS

PROJECT REFERENCE NO.	SHEET NO.
A-9WM	8
R/W SHEET NO.	
	HYDRAULICS ENGINEER

AS-BUILT PLANS

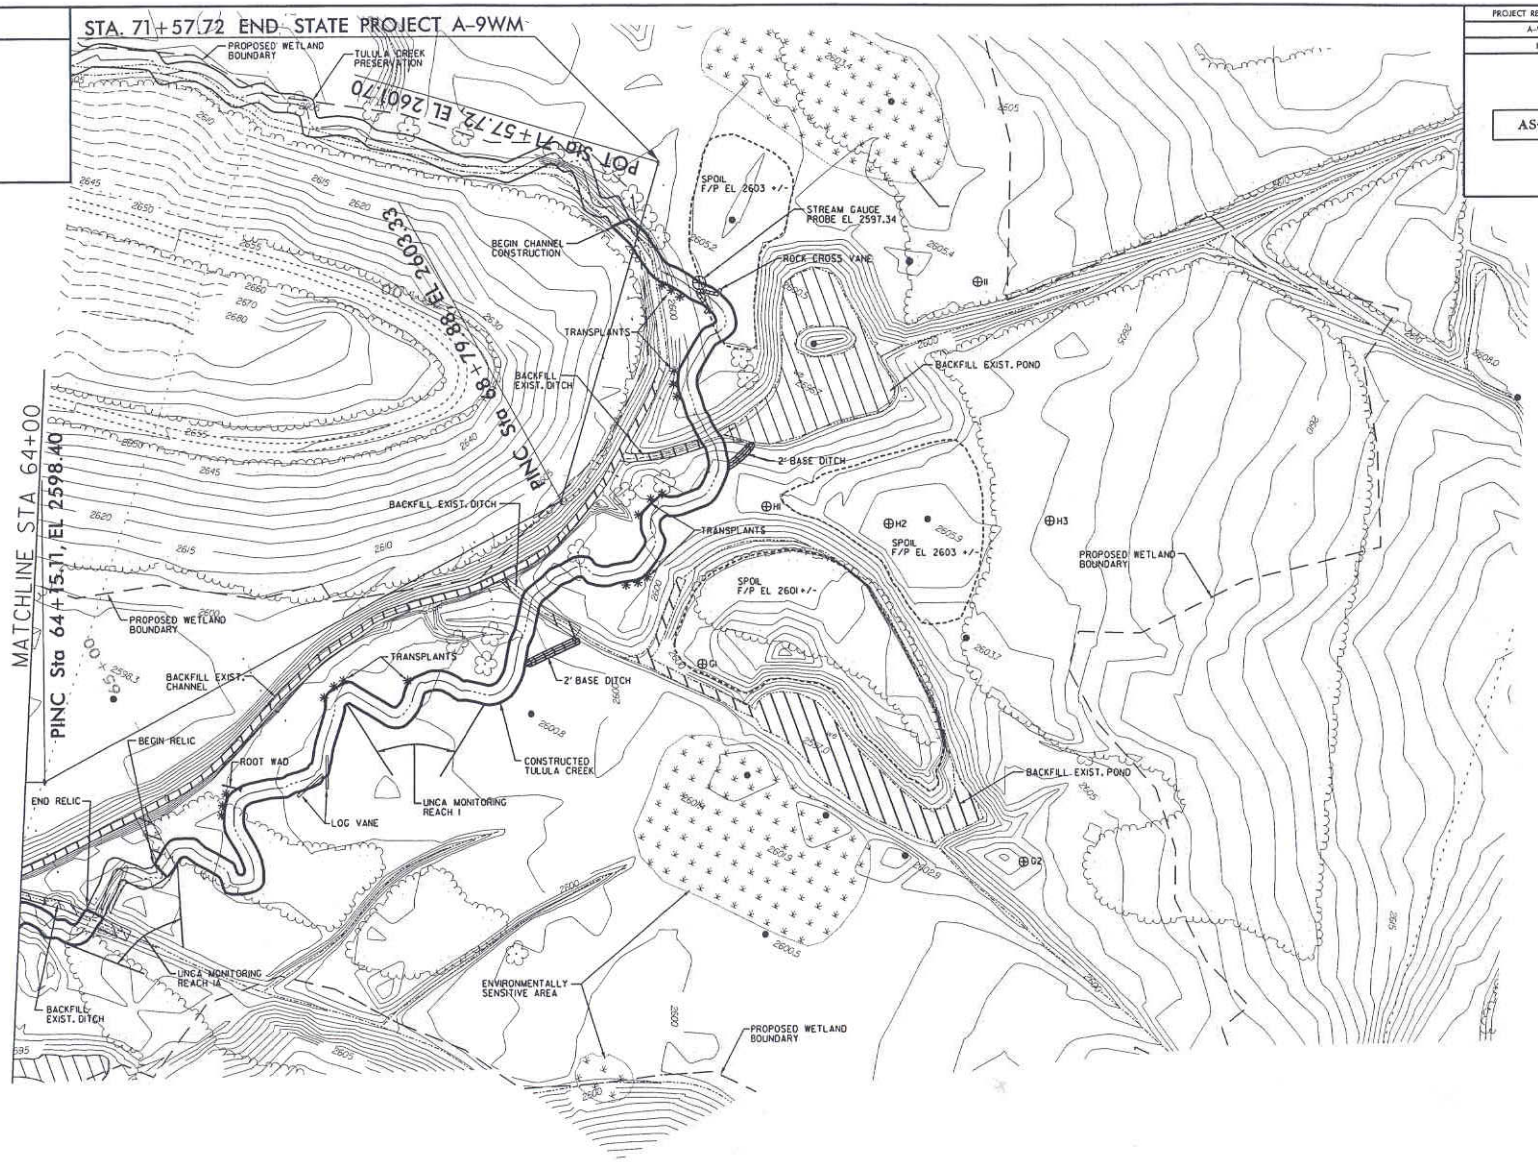

GRAPHIC SCALE

50 25 0 50 100

H S M M
ARCHITECTS - ENGINEERS - PLANNERS
1505 NAVAHO DR. SUITE 303 RALEIGH, NC 27609